


# KEY MAP



1 KEY PLAN  
1 SCALE: NOT TO SCALE

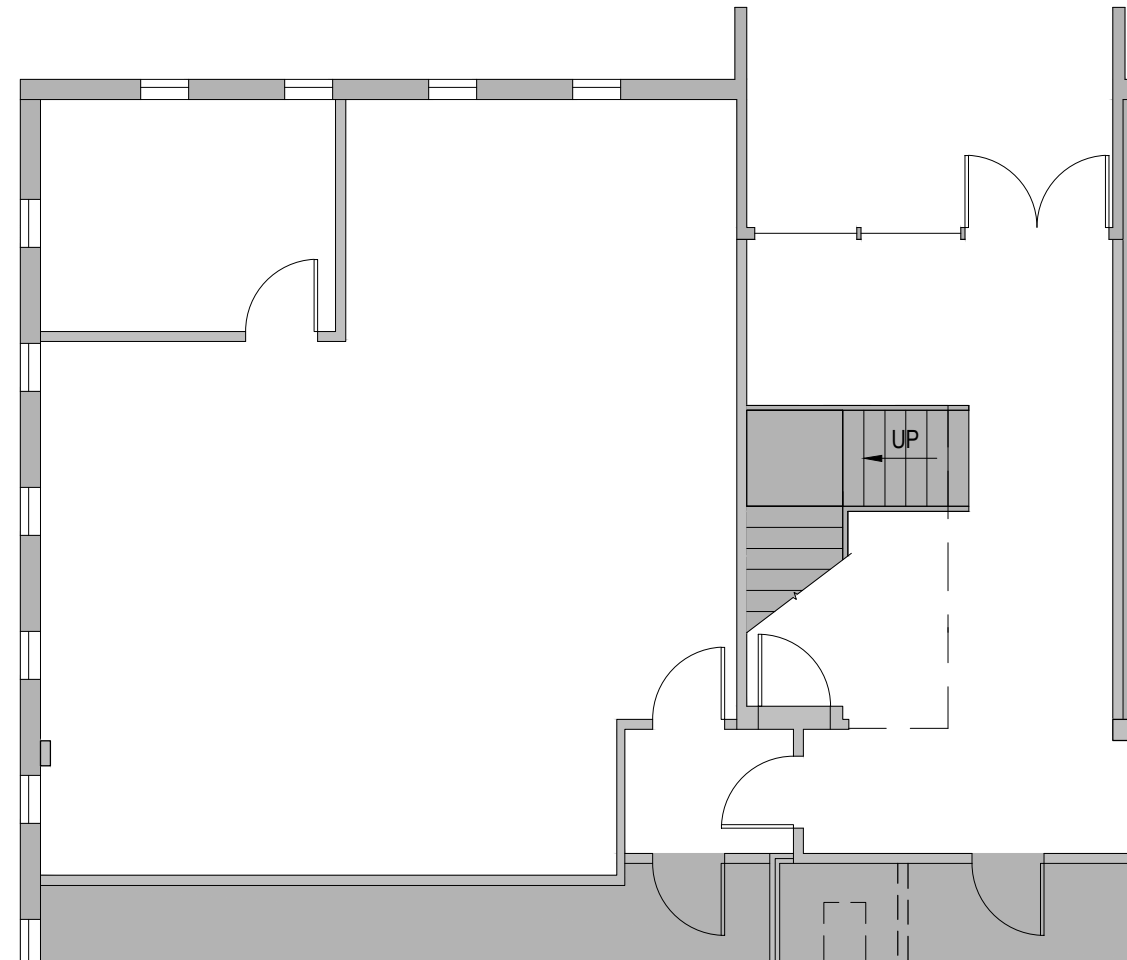

2 1ST FLOOR PLAN - SUITE 107 - 1,073 RSF  
1 SCALE: 1/8" = 1'-0"

0 4' 8' 16'  
SCALE: 1/8" = 1'-0"



NOT FOR  
CONSTRUCTION

**NELSON**  
Nelco Architecture, Inc. NELSONonline.com

CLIENT:	JCR DEVELOPMENT - PLAZA 451 BUILDING	DATE:	05/08/2019
PROJECT:	SUITE 107 AS-BUILT	DRAWN BY:	BMT
PROJECT NO.:	19.01101.00	REVIEWED BY.:	NG