


FORT DENT II
OFFICE BUILDING
TUKWILA, WASHINGTON

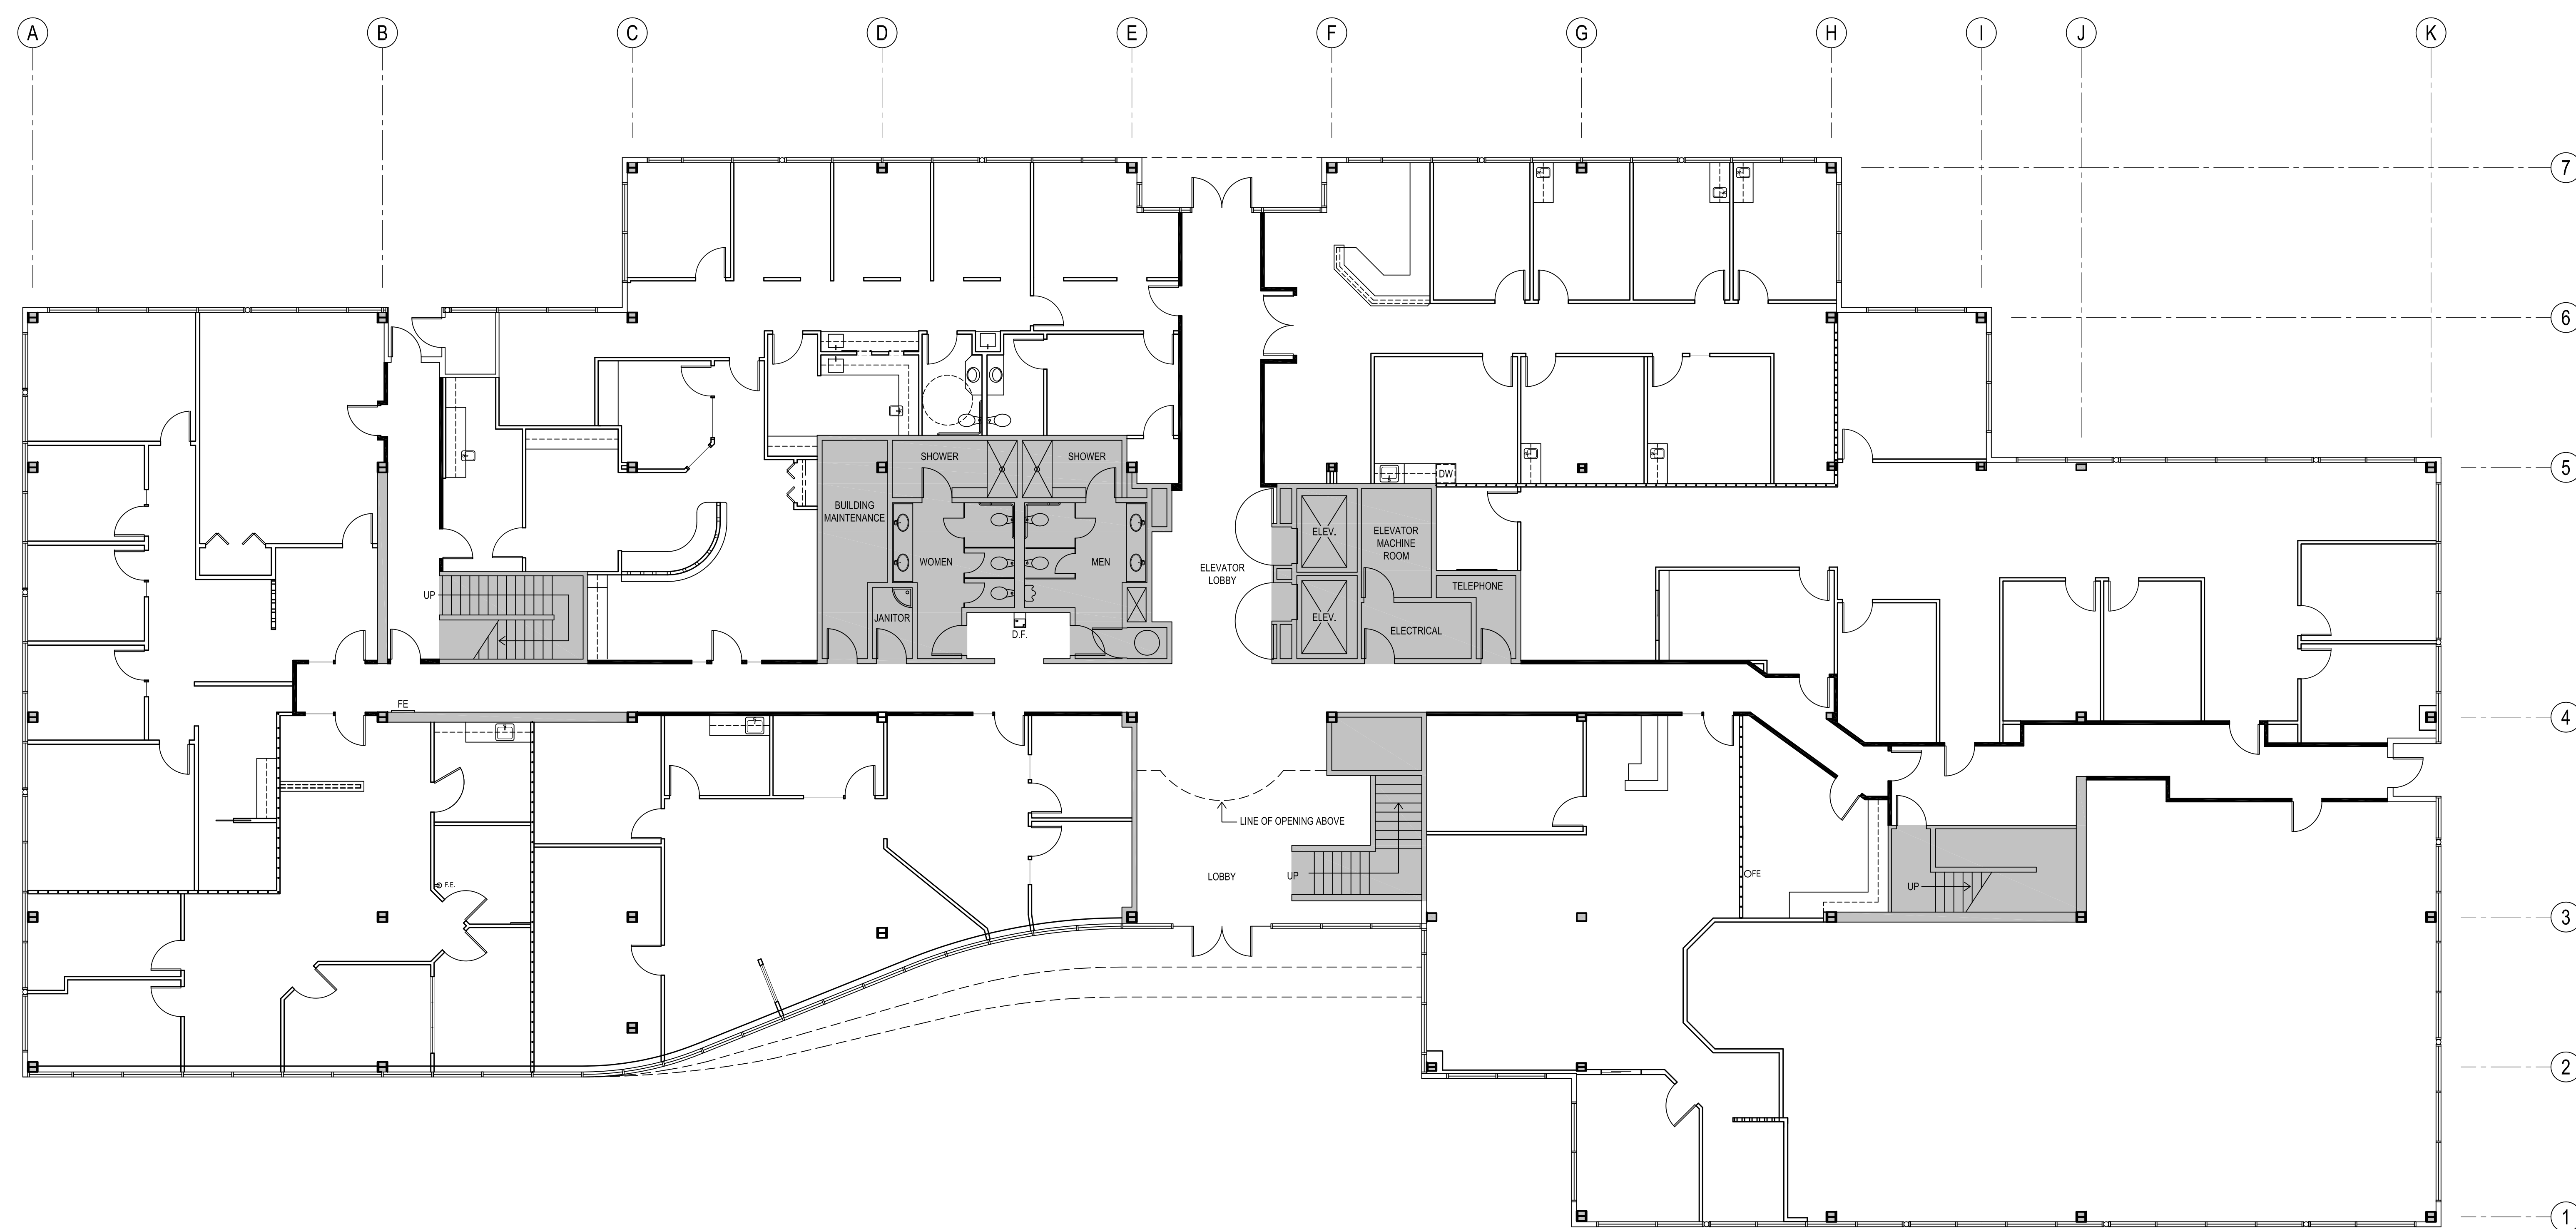

1 FIRST FLOOR PLAN
1/8" = 1'-0"
0 5' 10' 20' 30'
NORTH

MSA
MARVIN STEIN ASSOCIATES
2221 FIFTH AVENUE, SEATTLE WA 98121

DRAWN BY:
CHECKED BY:
JOB NO.:

NO.	REVISIONS INDICATED THIS	DATE	BY

TENANT:

SHEET TITLE:


FIRST FLOOR
ASBUILT

Date: Mar 11, 2013
Time: 9:53:07 AM
Drawing File: J:\BIDS\A\Fort Dent II\A-Builds\Floor 01\VDZ-AB-01.dwg
User: f22-ma-j

FORT DENT II

FORT DENT II OFFICE BUILDING

TUKWILA, WASHINGTON

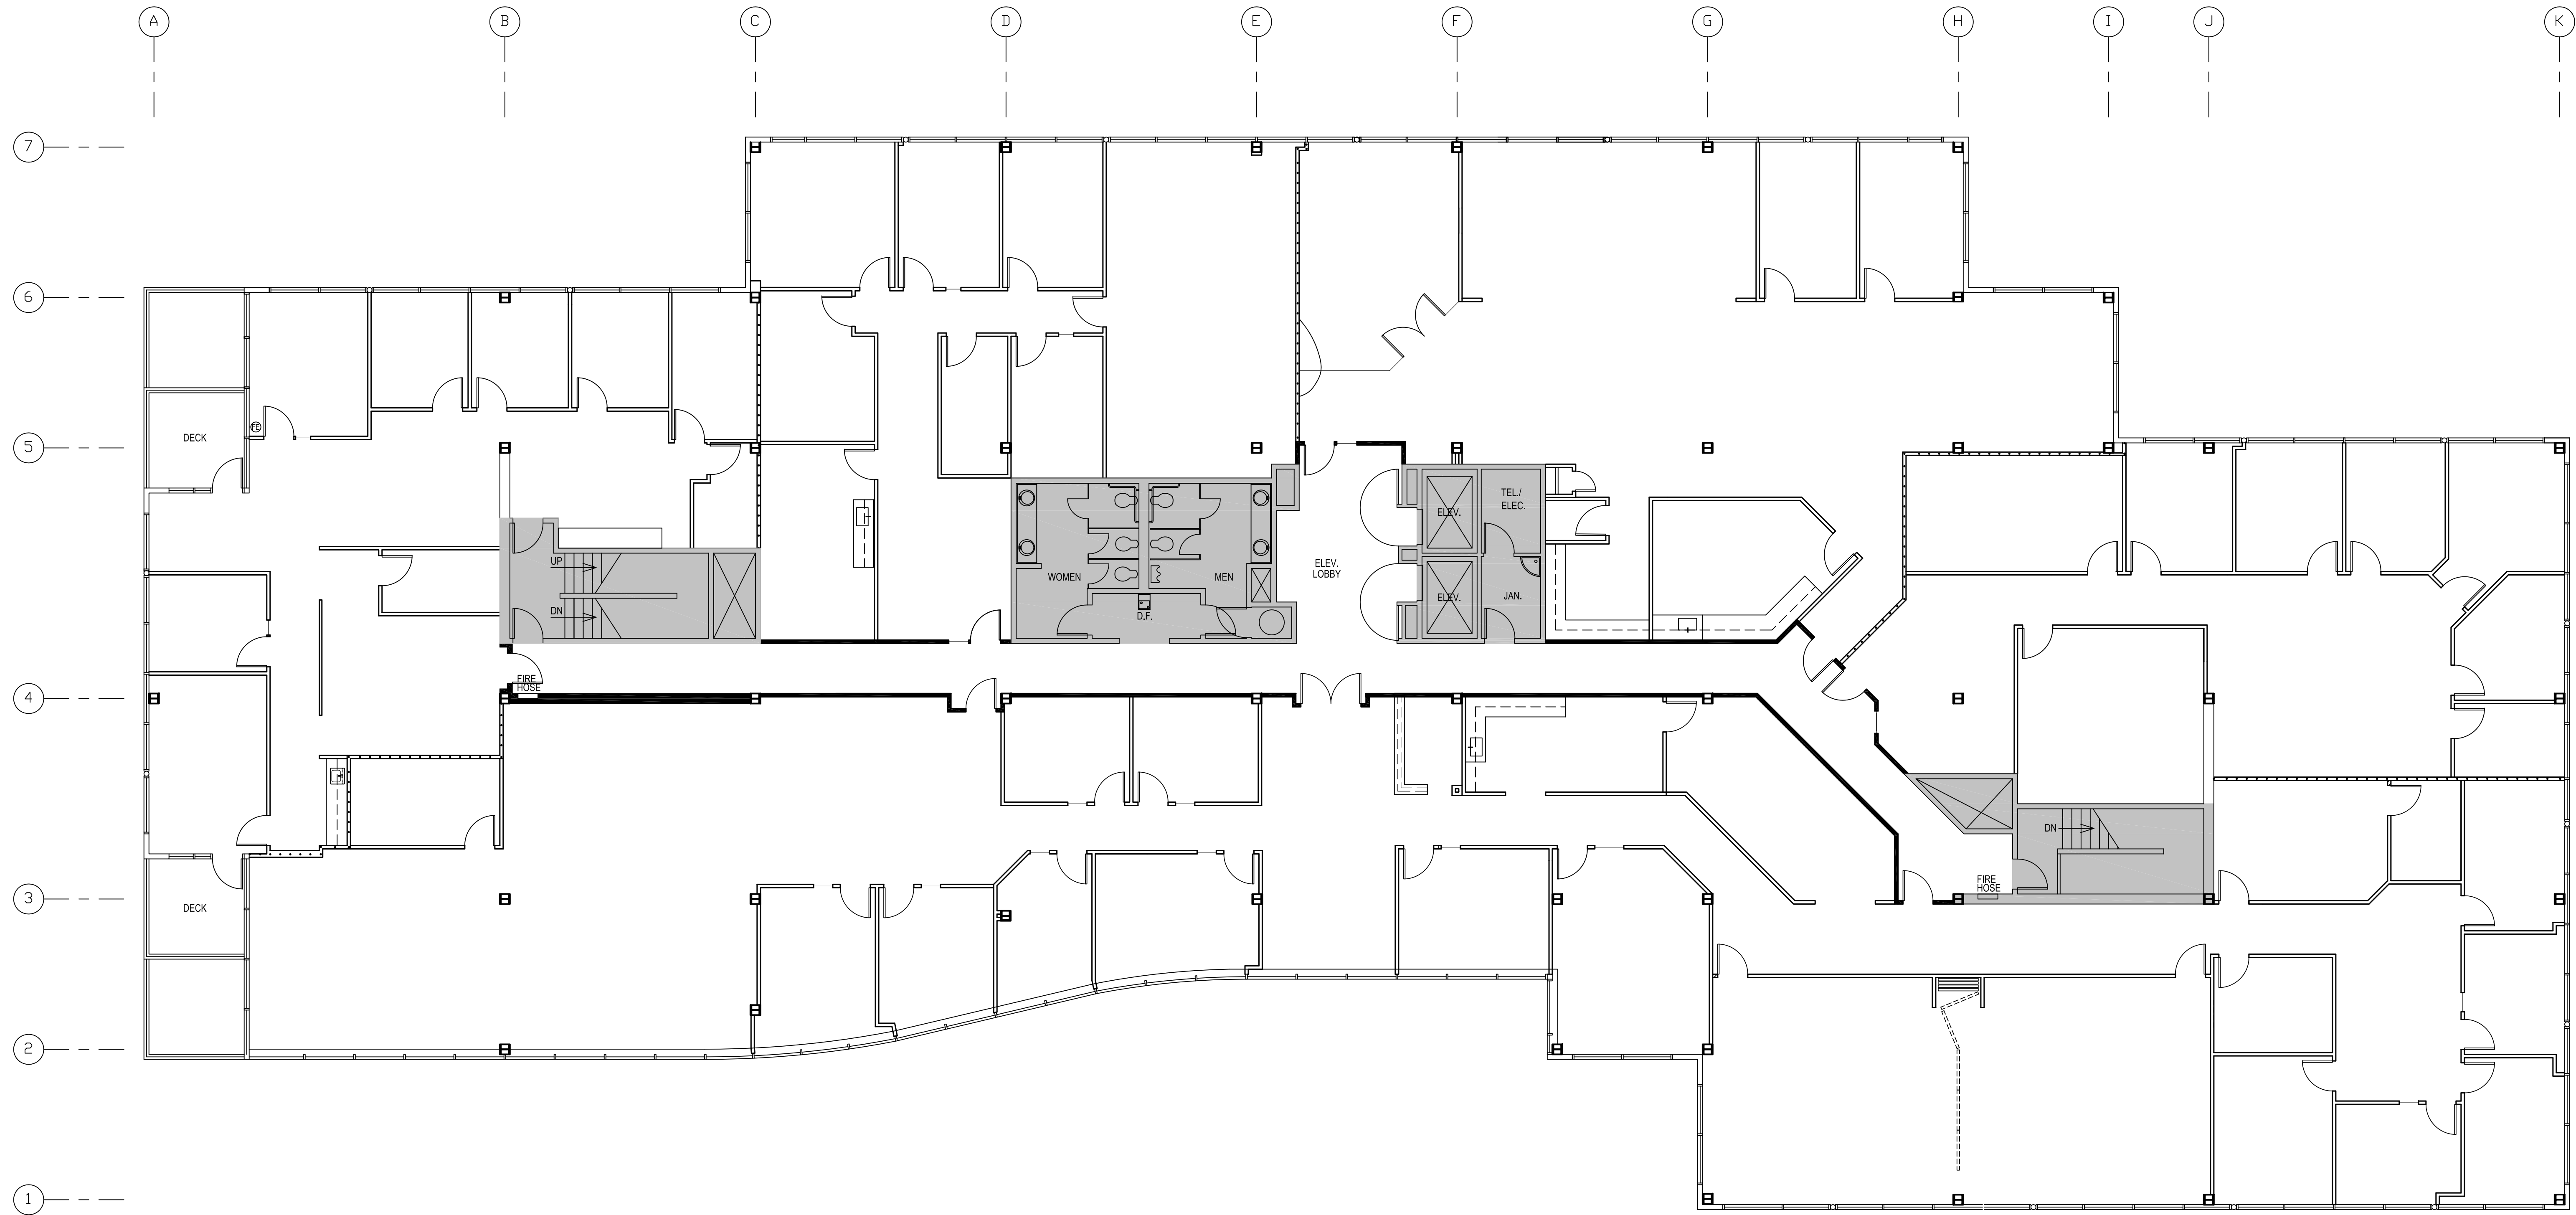

1 THIRD FLOOR PLAN
1/8" = 1'-0"
0 5' 10' 20' 30'
NORTH

MSA
MARVIN STEIN ASSOCIATES
2221 FIFTH AVENUE, SEATTLE WA 98121

DRAWN BY:

CHECKED BY:

JOB NO.:

NO.	REVISIONS INDICATED THUS \triangle	DATE	BY

TENANT:

SHEET TITLE:

THIRD FLOOR
ASBUILT

REPRODUCTION, ALTERATION OR PUBLICATION OF THIS DRAWING, WITHOUT EXPRESSED PERMISSION BY MSA&A, IS A VIOLATION OF FEDERAL COPYRIGHT LAW. COPYRIGHT BY MSA&A 2012.

Date: Mar 15, 2013
Time: 12:24:00 PM
Drawing File: J:\BID\SSA\Fort Dent II\As-Built\Floor 03\FDI-AB-03.dwg
User: J22-MA-03

FORT DENT II