



FORT DENT II
OFFICE BUILDING

TUKWILA, WASHINGTON

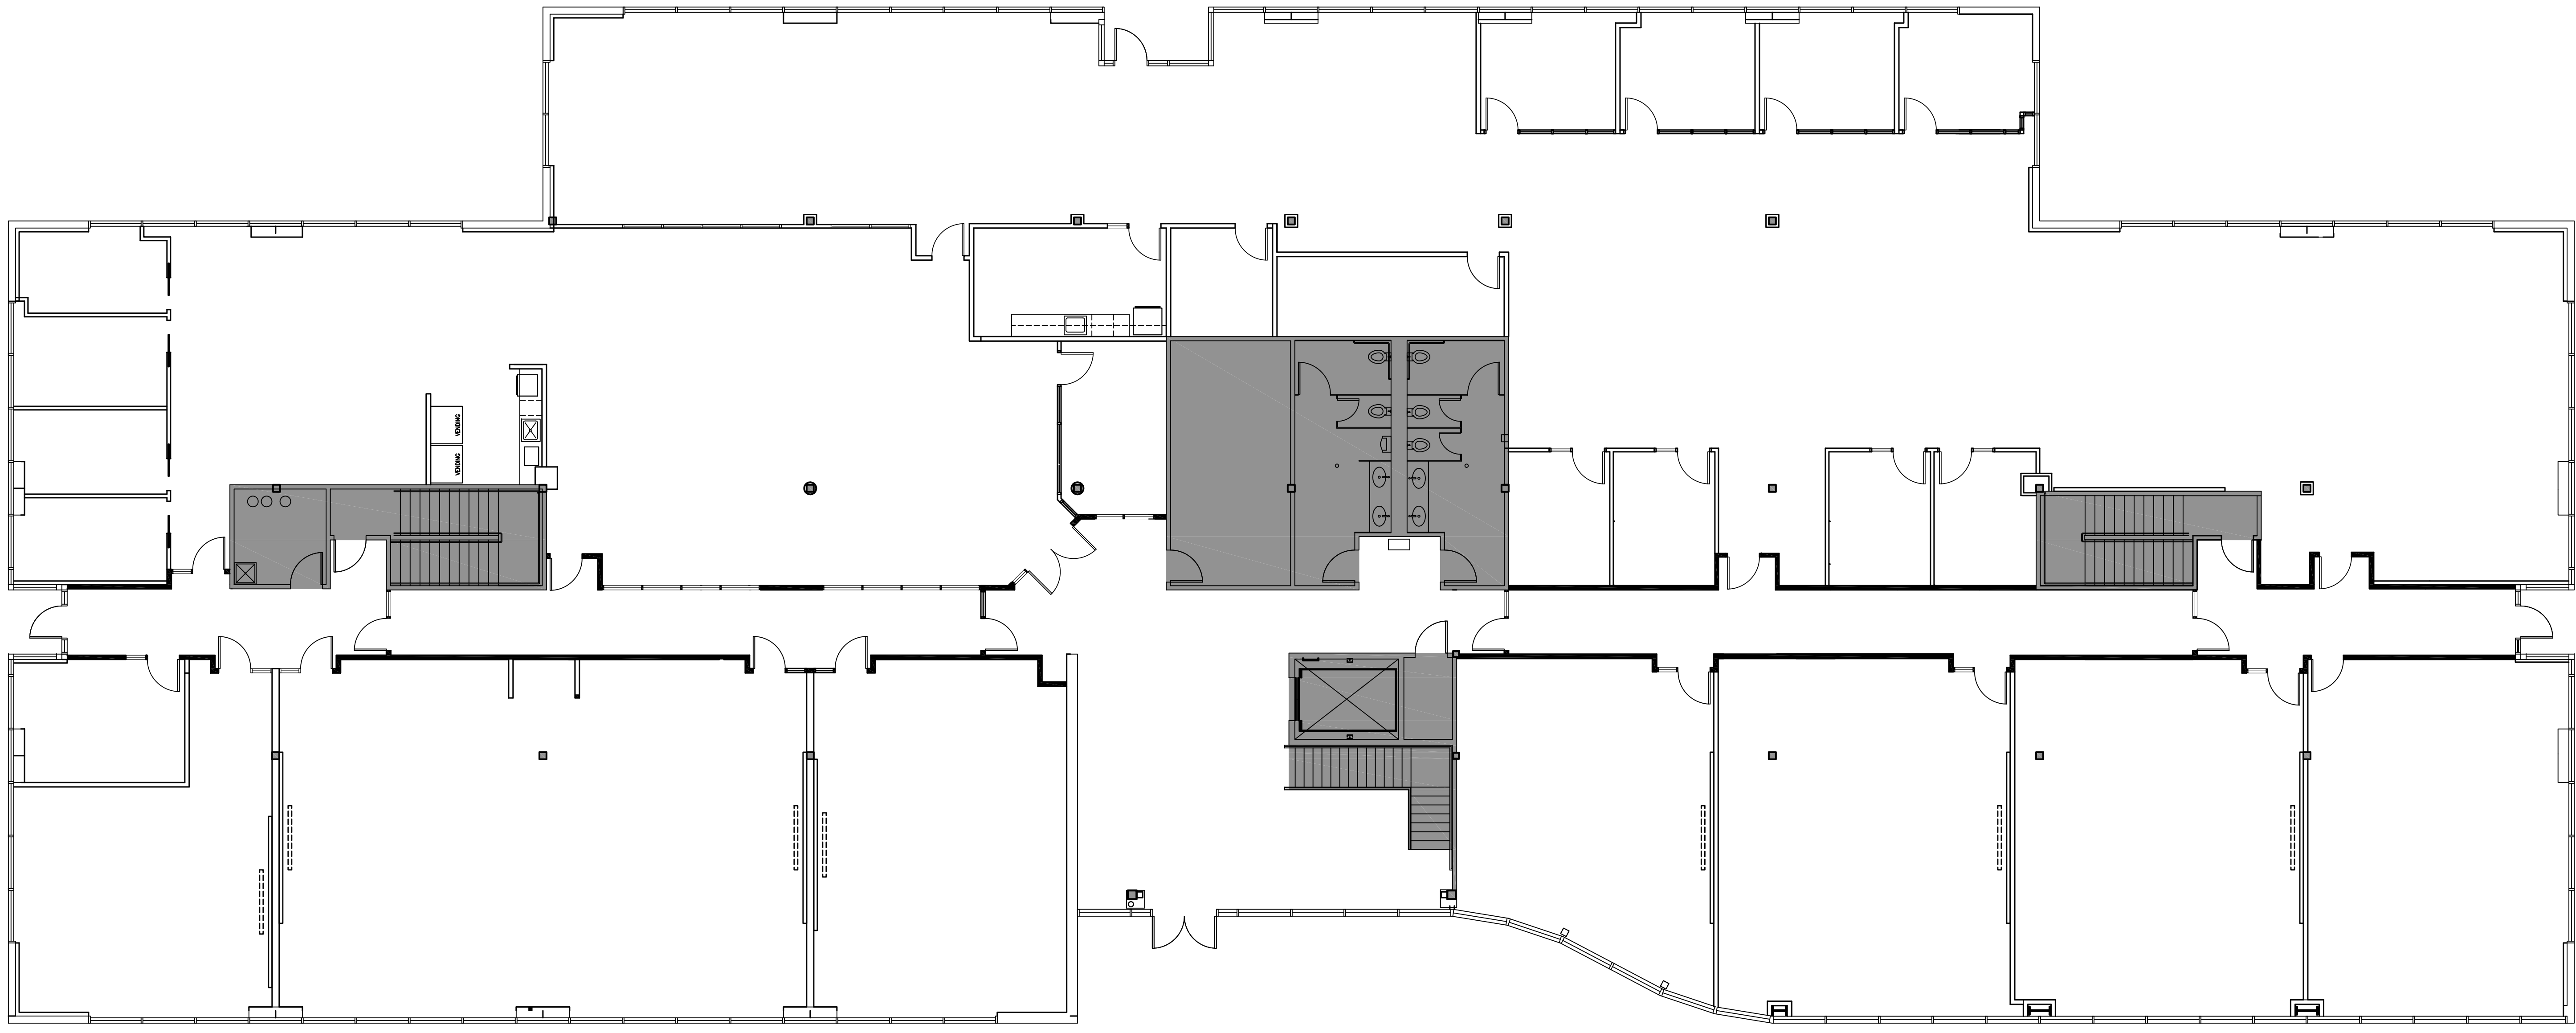

1 FIRST FLOOR PLAN

1/8" = 1'-0"

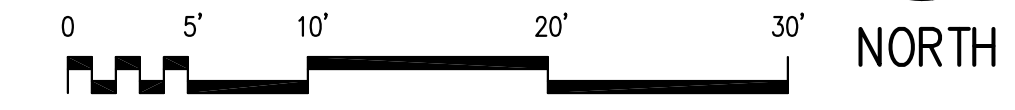

MSA
MARVIN STEIN ASSOCIATES

2221 FIFTH AVENUE, SEATTLE WA 98121

DRAWN BY:

CHECKED BY:

JOB NO.:

NO.	REVISIONS INDICATED THUS	DATE	BY
	△		

TENANT:


SHEET TITLE:

FIRST FLOOR
ASBUILT

REPRODUCTION, ALTERATION OR PUBLICATION OF THIS
DRAWING WITHOUT EXPRESSED PERMISSION BY MSA&A, IS
A VIOLATION OF FEDERAL COPYRIGHT LAW. COPYRIGHT
BY MSA&A 2012.

**FORT DENT II
OFFICE BUILDING**

TUKWILA, WASHINGTON

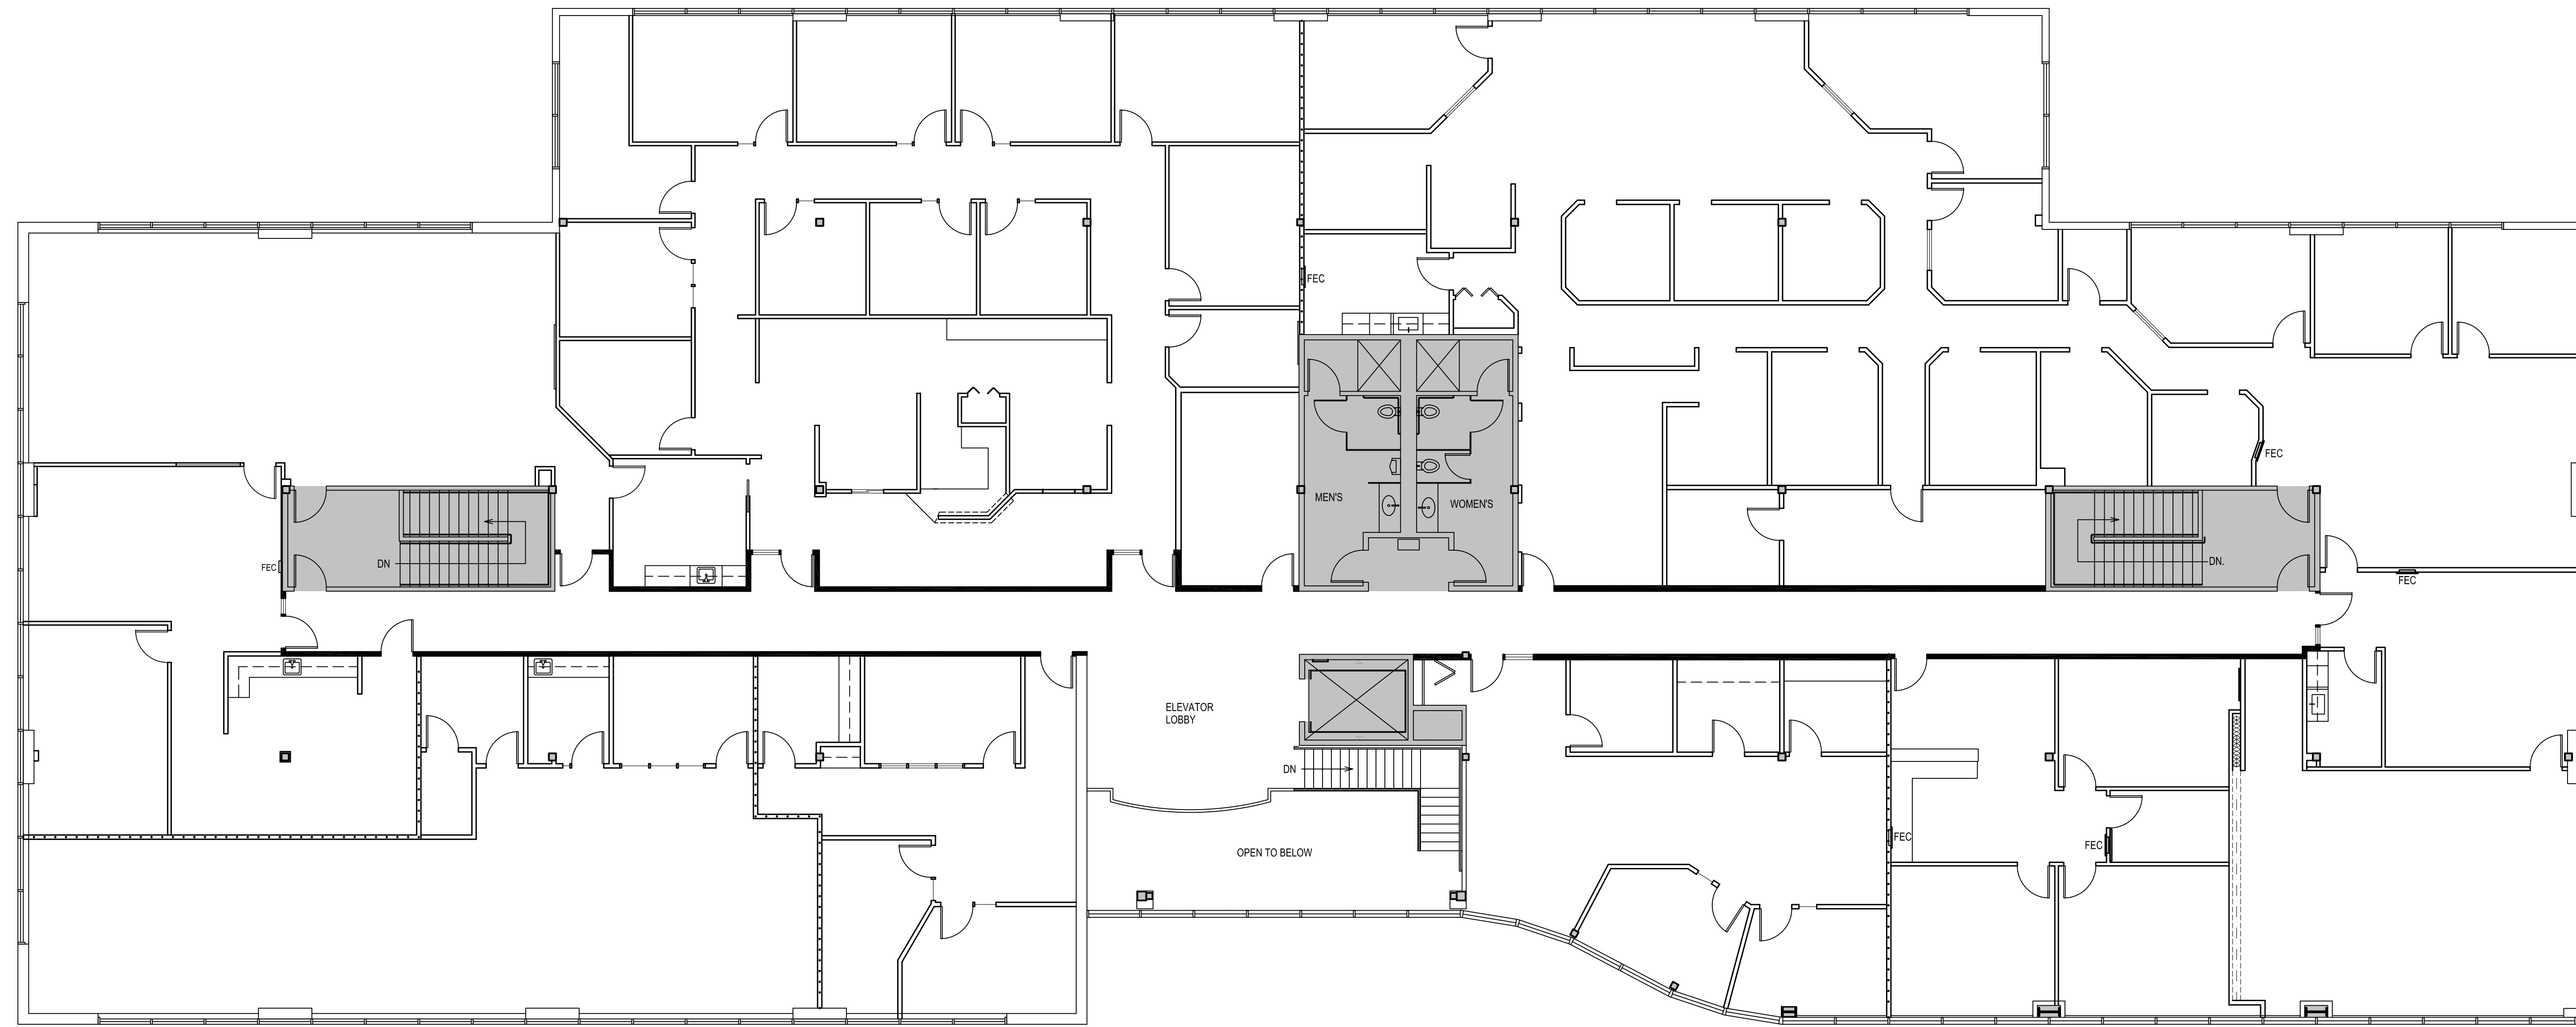

1 SECOND FLOOR PLAN
1/8" = 1'-0"
0 5' 10' 20' 30'
NORTH

MSA
MARVIN STEIN ASSOCIATES
2221 FIFTH AVENUE, SEATTLE WA 98121

DRAWN BY:

CHECKED BY:

JOB NO.:

NO.	REVISIONS INDICATED THUS Δ	DATE	BY

TENANT:

SHEET TITLE:

**SECOND FLOOR
ASBUILT**

REPRODUCTION, ALTERATION OR PUBLICATION OF THIS DRAWING WITHOUT EXPRESSED PERMISSION BY MSA&A, IS A VIOLATION OF FEDERAL COPYRIGHT LAW. COPYRIGHT BY MSA&A 2012.

Date: Mar 11, 2013
Time: 11:40:00
Drawing File: \\blj005\A-F\Fort Dent II\As-Built\Floor 02\FD2-AB-02.dwg
User: P33-MA-02

FORT DENT II