
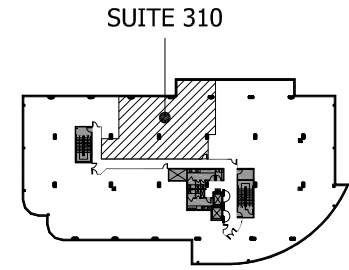


1 AS-BUILT PLAN  
SHT. 1 1" = 10'-0"

Scale:

Client: JCR DEVELOPMENT COMPANY	Scale: PER PLAN
Project: SOUTH 405 PLACE - SUITE 310	Date: 04/13/18
Proj. No.: MS.00971.00	Drawn By: NG

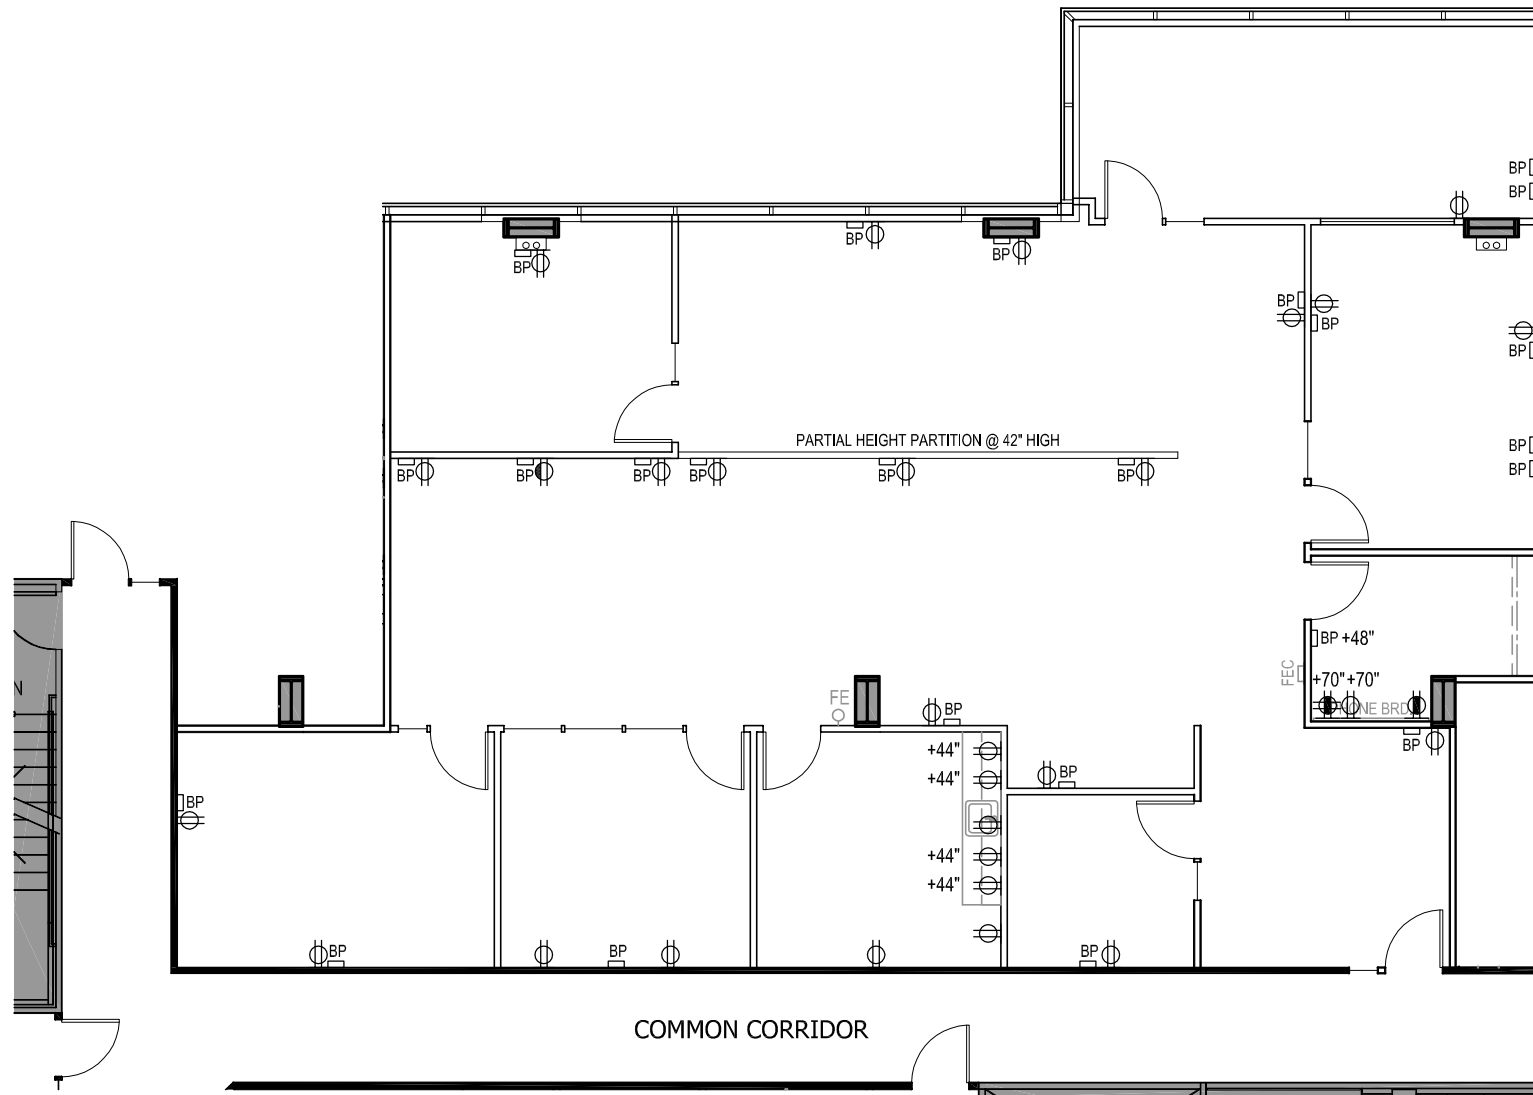

- ELEC / COMMUNICATIONS LEGEND**
- B/S DUPLEX ELECTRICAL OUTLET
  - B/S DEDICATED ELECTRICAL OUTLET
  - B/S DEDICATED FOURPLEX OUTLET
  - B/S COMBINATION VOICE/DATA OUTLET
  - BLANK PLATE

**AS-BUILT PLAN - POWER & VOICE/DATA**  
 1 SHT. 1  
 1" = 10'-0"  
 Scale:

Client: JCR DEVELOPMENT COMPANY  
 Project: SOUTH 405 PLACE - SUITE 310  
 Proj. No.: MS.00971.00

Scale: PER PLAN  
 Date: 04/13/18  
 Drawn By: NG

Sheet No.:  
**2 OF 2**