



KEY MAP



1 KEY PLAN
1 SCALE: NOT TO SCALE

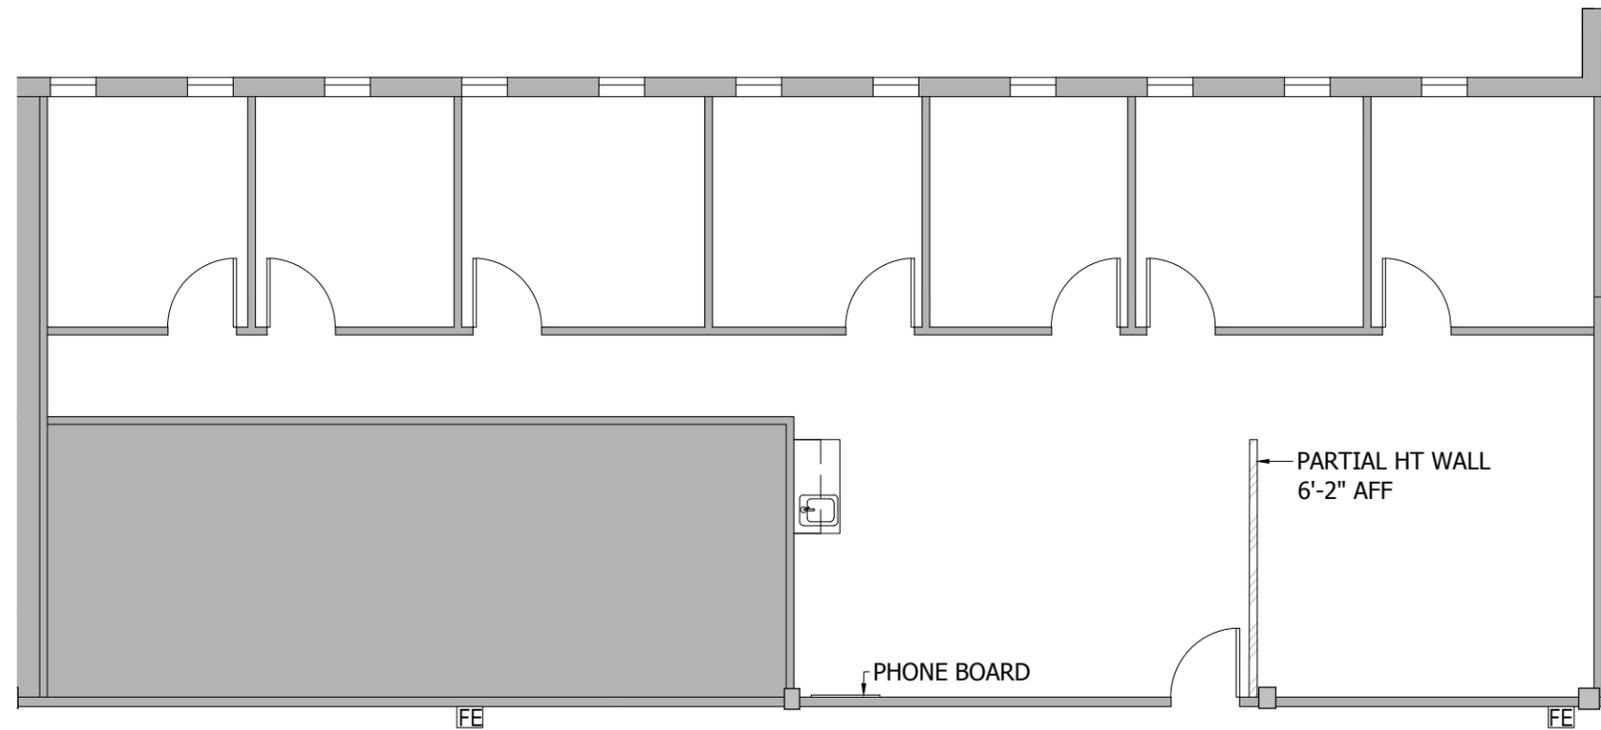

2 2ND FLOOR PLAN - SUITE 216 - 1,629 RSF
1 SCALE: 1/8" = 1'-0"

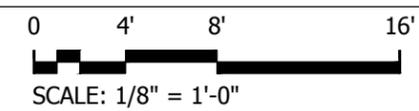

NOT FOR
CONSTRUCTION

NELSON
Nelco Architecture, Inc. NELSONonline.com

CLIENT:	JCR DEVELOPMENT - PLAZA 451 BUILDING	DATE:	05/08/2019
PROJECT:	SUITE 216 AS-BUILT	DRAWN BY:	BMT
PROJECT NO.:	19.01101.00	REVIEWED BY:	NG